MAX LIVE LOAD +/- 8mm.

10

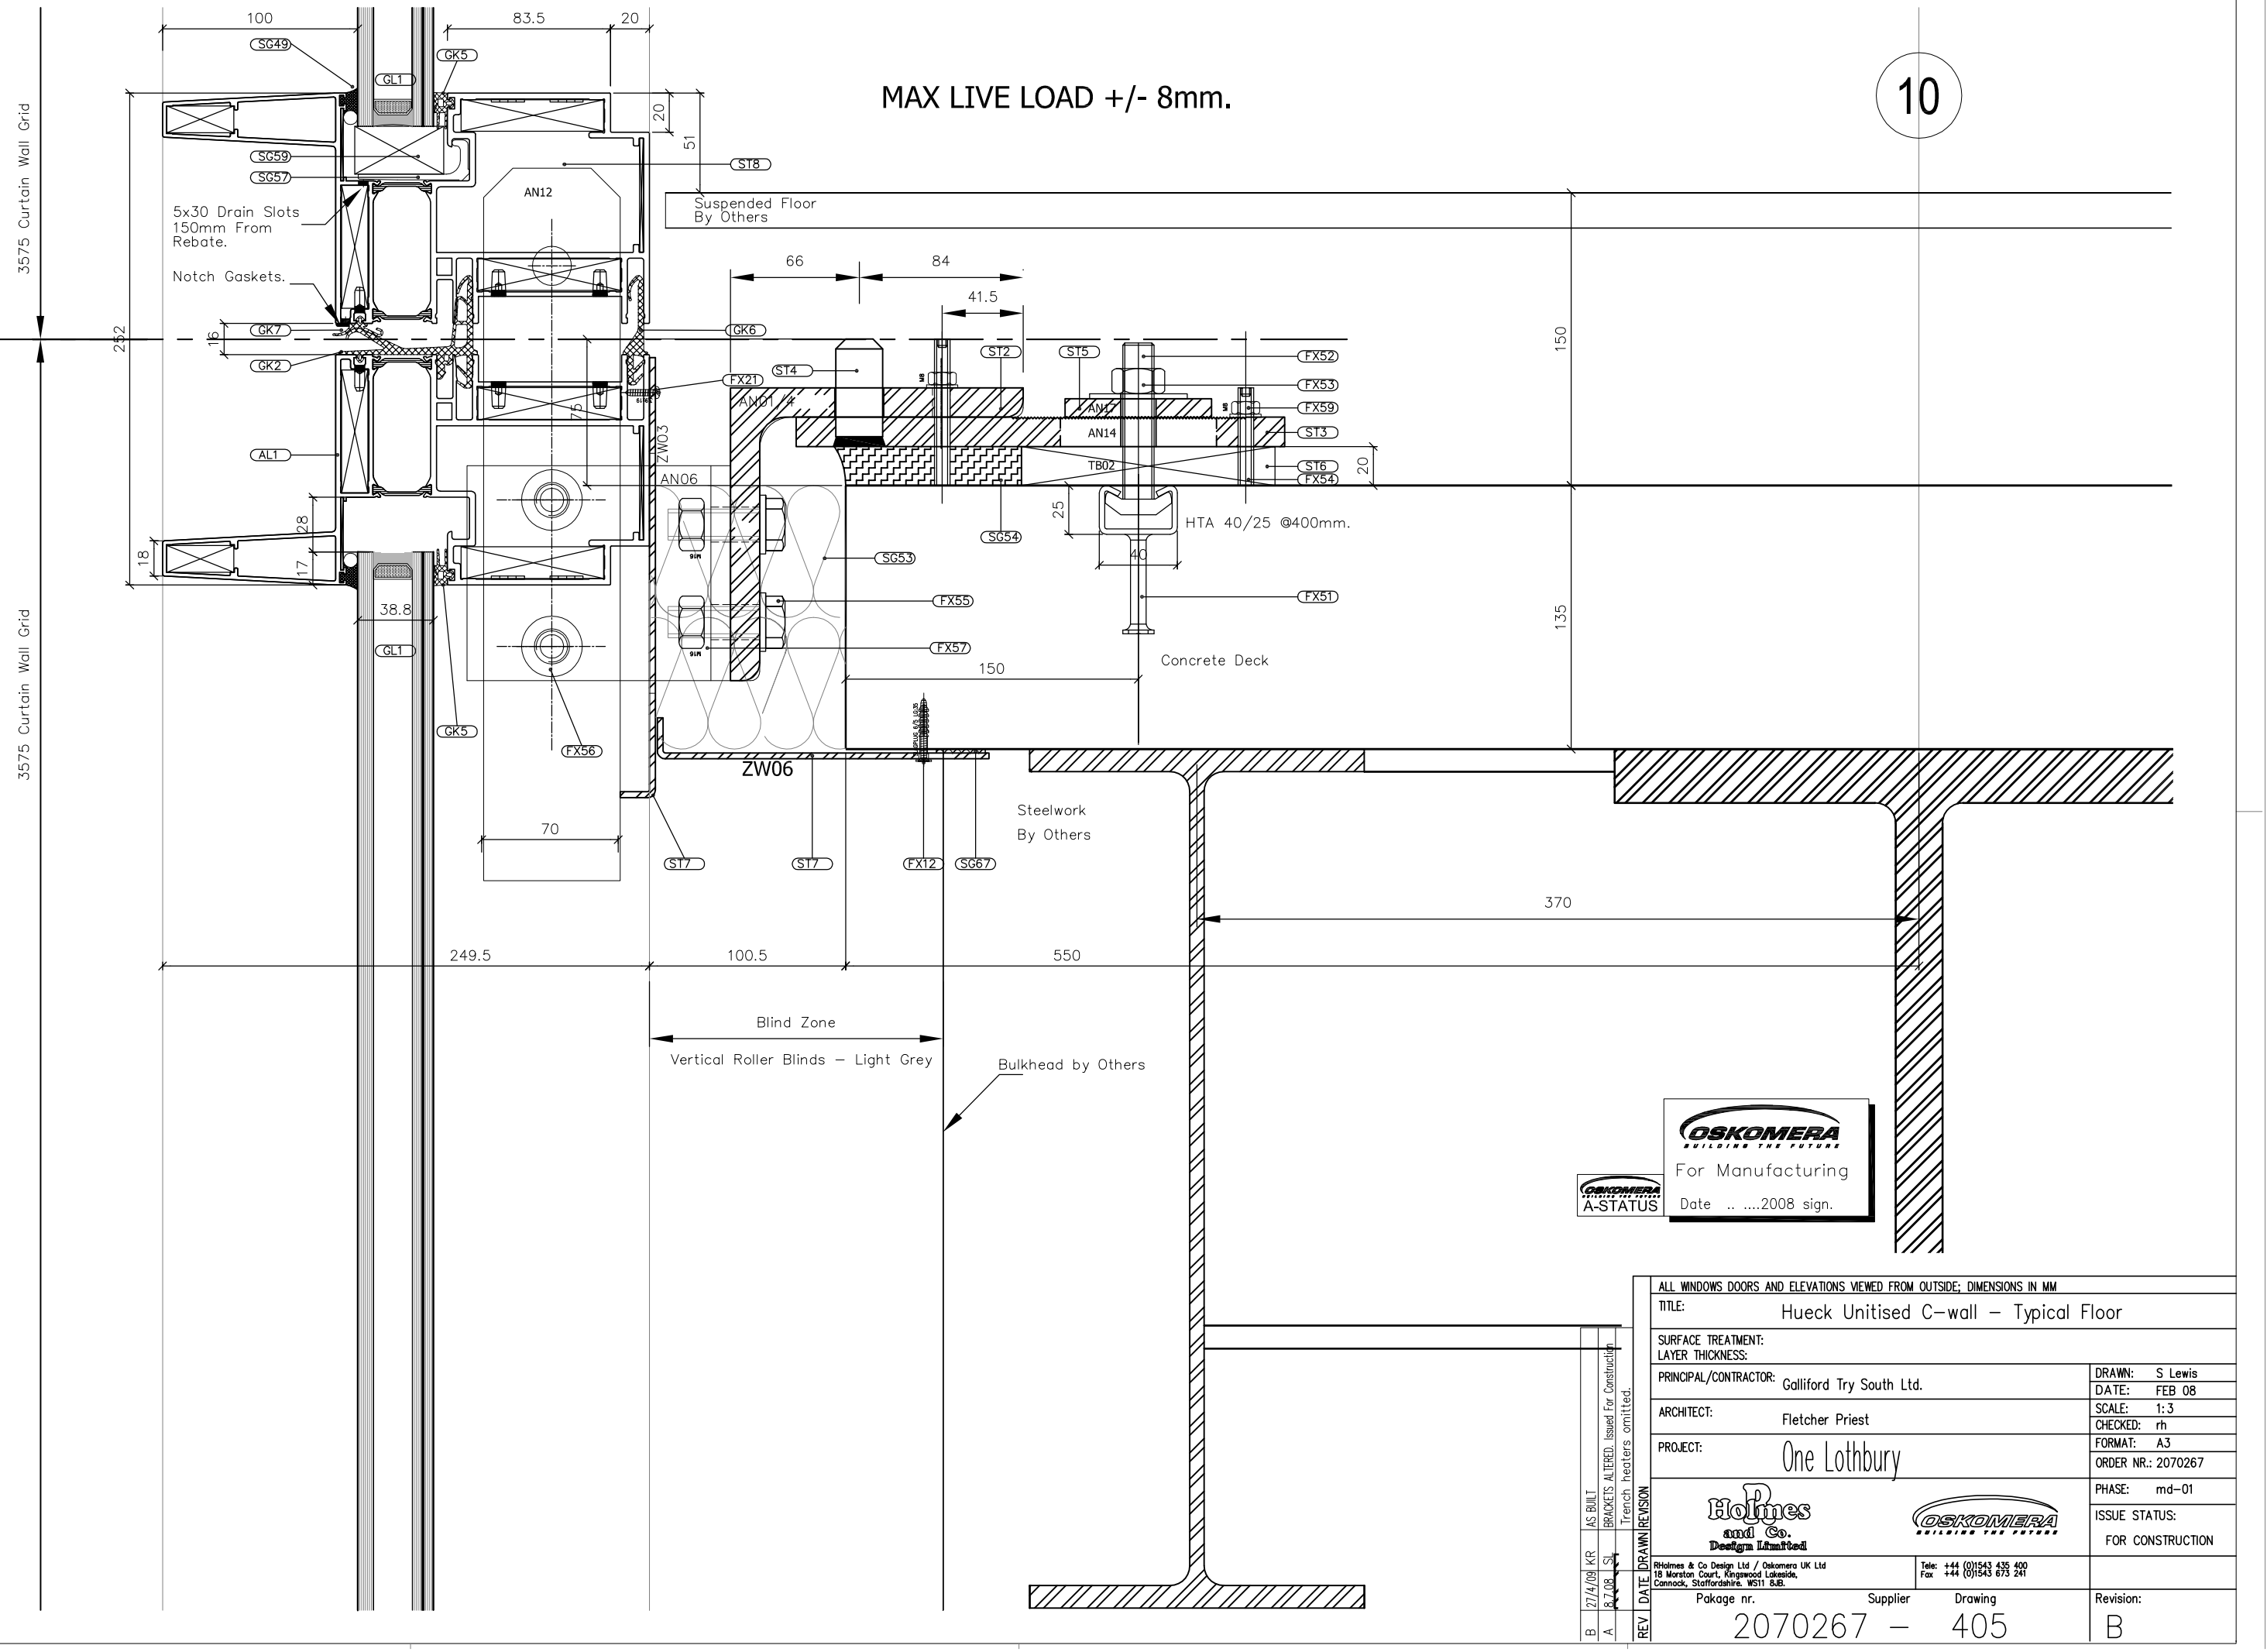

REV	DATE	DRAWN	RE-VISION
B	27/4/09	KR	AS BUILT
A	8.7.08	SL	BRACKETS ALTERED. Issued for Construction
			Trench heaters omitted.

ALL WINDOWS DOORS AND ELEVATIONS VIEWED FROM OUTSIDE; DIMENSIONS IN MM

TITLE: Hueck Unitised C–wall – Typical Floor

SURFACE TREATMENT:
LAYER THICKNESS:

PRINCIPAL/CONTRACTOR: Galliford Try South Ltd.

ARCHITECT: Fletcher Priest

PROJECT: One Lothbury

DRAWN:	S Lewis
DATE:	FEB 08
SCALE:	1:3
CHECKED:	rh
FORMAT:	A3
ORDER NR.:	2070267
PHASE:	md–01
ISSUE STATUS:	FOR CONSTRUCTION

RHolmes & Co Design Ltd / Oskomera UK Ltd
18 Morston Court, Kingswood Lakeside,
Cannock, Staffordshire. WS11 8JB.
Tele: +44 (0)1543 435 400
Fax +44 (0)1543 673 241

Pakage nr.	Supplier	Drawing	Revision:
2070267	–	405	B